CSX How tomorrow moves

PAGE: 24607

DATE EXPORTED: 05/03/2017

- Val Map Mileposts
- Active Road Crossings
  - At Grade
  - RR Over
  - RR Under
- RR Crossings (Diamonds)
  - At Grade (Diamonds)
  - RR Over
  - RR Under

No.	REVISION	REFERENCE	DATE PLOTTED	AFE	BY
1.	TRACK ABANDONED	AB55-455X IN 14A	12-17-03	UNKNOWN	B.B.R.
2.	TRACK ABANDONED	AB55-634X IN 14F	12-7-05	A30987	B.B.R.

A.F.E. NOTES CONT'D

6003	McDoel	Construct New Spur Track 290 ft long - W B Hoadley	Completed	Mar 1932
6079	"	Construct New X-over bet Main Track & 81	"	Oct 1930
6444	Bloomington	Retire 55 1/2 ft from End of Showers Bros Track 6	"	Aug 1933
7045	McDoel	Construct an Extension of 120 ft to Trk of W B Hoadley	"	Aug 1936
8124	"	Construct 60 ft Additional Wheel Track	"	Sept 1940
8431	Bloomington	Construct New Trk 608 ft long for Thompson-Weimon	"	July 1941
8782	McDoel	Retire 2460 ft off S. End of Track 81 1505 ft of Trk 89 All of Trk 94	"	May 1943
8935	"	Retire Track #1 and #2	"	Sept 1942
9135	"	Retire S End X-over Trk 94	"	Oct 1944

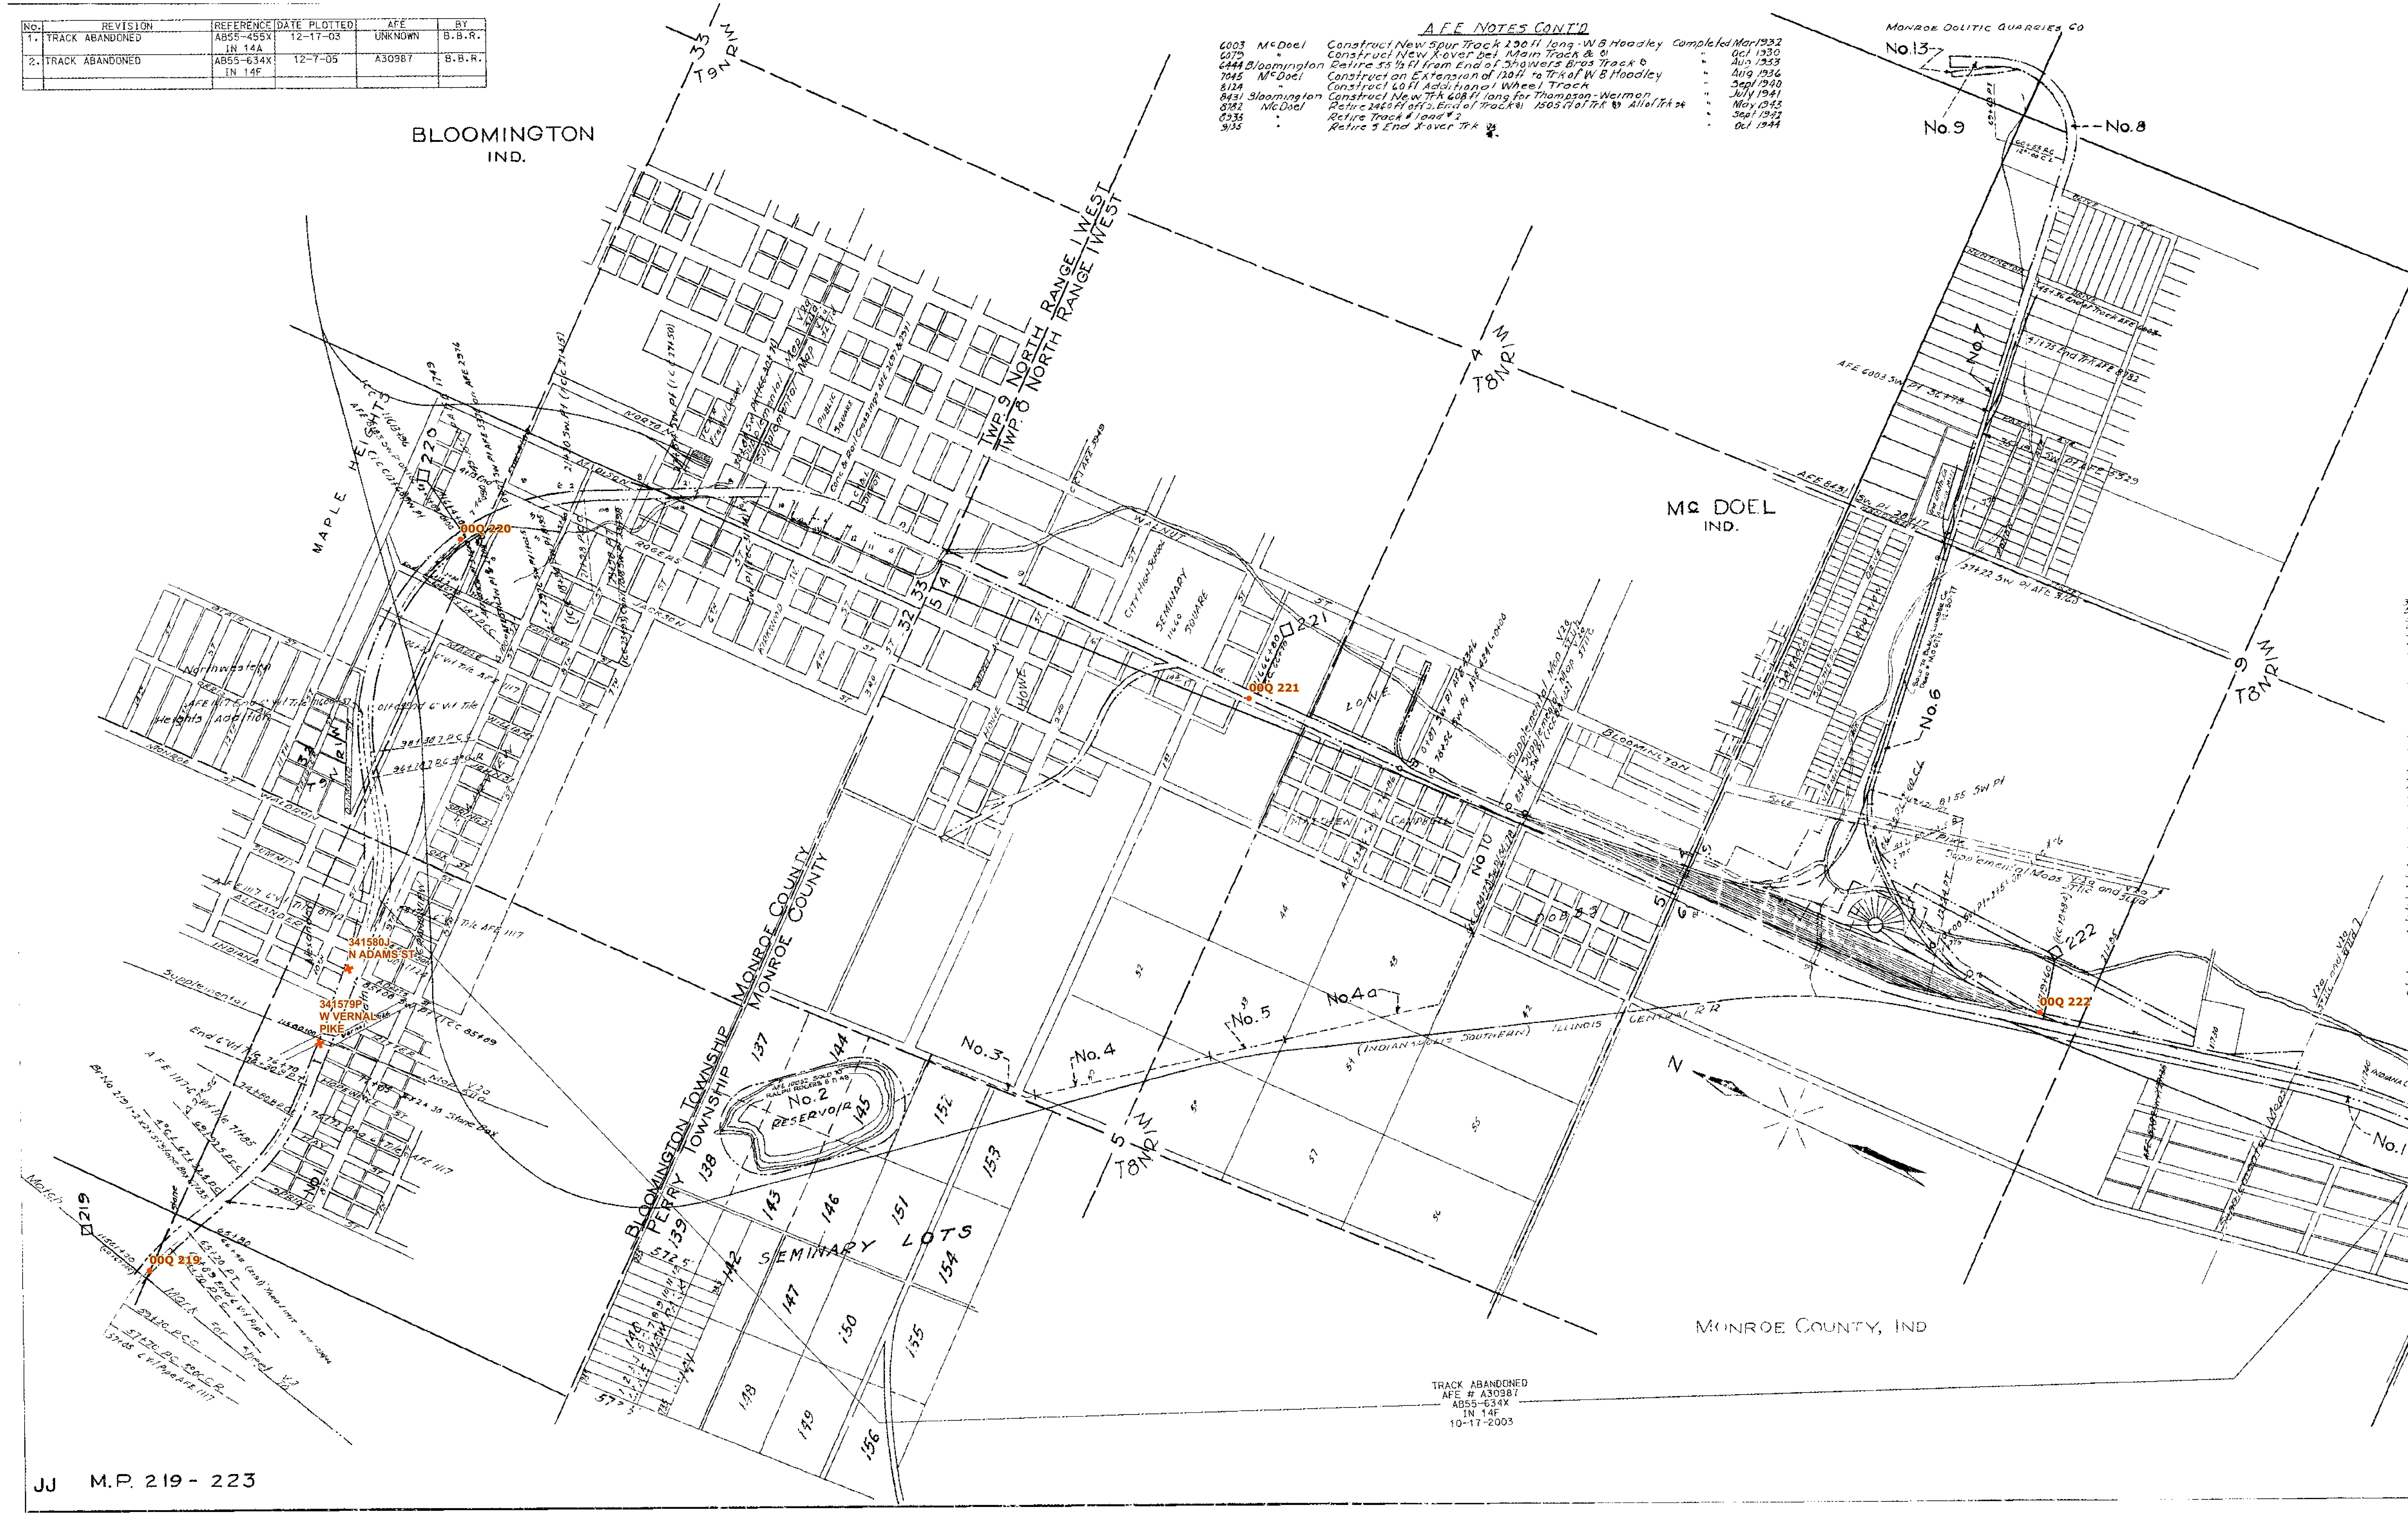

No	GRANTOR	GRANTEE	INSTRUMENT	DATE	RECORD	CUST. No	REMARKS
1							N A & S Charter
2	Oscar G Miller et al	C I & L Ry	Circuit Court	June 6, 1913	QT Rec 2 Pg 99-100 Sept 19 1932	MO - 194	
2	Livingston T Dickason	C I & L Ry	Warranty	Dec 22, 1902	DB 43 Pg 242-243 Dec 27, 1902	MO - 49	
3							St Used for Pipe Line
4	Sarah G Duncon	C I & L Ry	Contract	June 13, 1902	Misc Rec 4 Pg 387 Sept 18, 1902	MO 41	
4a	"	"	"	"	"	"	
5	Gentry Bros	"	"	June 30, 1902	" " 386 "	MO 40	
6	A Helton Pauley et al	"	Condemnation	May 7, 1912	Civil Rec 45 Pg 344 S "	MO 67 1/2	Book A 5
7	Joseph K Barclay et al	"	"	"	"	" "	" "
8	Monroe Quarries Co	"	Quit Claim	July 12, 1912	DB 59 Pg 265 Aug 14, 1912	" 67	
9	" "	"	Warranty	July 14, 1913	DB 60 Pg 462 July 26, 1913	" 52	
10							St Used for Pipe Line
11							N A & S Charter
12							N A & S Charter
13							No Record
~~14~~	~~Pedrick AW Wylie~~	~~W W Wicks~~	~~Warranty~~	~~Nov 3, 1906~~	~~D B 50 Pg 88~~		~~Not C I & L Property~~ Indiana Creosoting Co
~~15~~	~~E J Denton et al~~	~~Ind Creosoting Co~~	~~Warranty~~	~~Oct 23, 1908~~	~~D B 53 Pg 126~~		~~Not C I & L Property~~
14	American Creosoting Co	Ind Creosoting Co	Warranty	July 3, 1961	DB 139 Pg 257 July 18, 1961		
15	"	"	"	"	" "		

14-15 Indiana creo. co. L & N INVEST. WARRANTY 2-25-1993 BK 218 PG.38 15357

FENCE SCHEDULE

M-11 11576+07 11598+60 11601+86 11603+60

A.F.E. NOTES CONT'D

32[illegible]	Bloomington	Assessment for Improvement of 4th St	Completed	May 1923
3264	"	Shift Present Lead of Hughes Bros Coal Co Track	"	Mar 1924
3549	"	Extend Trk for Graham Motor Car Sales Co 66 ft	"	Aug 1924
3547	"	Construct SW & Lead to Cl Pt for John Kerr	"	Sept 1924
3714	"	Assement for Sanitary Sewer	"	Apr 1925
3740	McDoel	Retire Transfer Platform	"	July 1926
3844	"	Install 8000 Gal Fuel Oil Storage Tank	"	Oct 1925
3851	"	Retire Track used by J N Nolan & Sons	"	Mar 1926
3949	Bloomington	Provide Track for Gas, Light & Heating Co	"	Feb 1926
4067	McDoel	Purchase 2.34 Ac Land from Eliza E Pope	"	Mar 1926
4273	"	Construct 2 New Tracks for Coal Storage	"	Jan 1927
4310	Bloomington	Assessment for Construction of Sewerage Disposal Plant	"	Oct 1926
4346	McDoel	Retire 110 ft of Track 86 to make way for Cline Track	"	Feb 1927
4514	"	Purchase lots 22, 23, 24 & 25	"	May 1927
4582	"	Construct New Wye Track 1220' long	"	Oct 1927
4588	Bloomington	Construct Additional Interchange Track with I C R R	"	Nov 1928
4601	"	Extend Track built under A F E 4346 for Hoadley Cline Co	"	Dec 1927
4608	McDoel	Change Channel of Clear Creek & Construct New I Beam Bridge	"	Dec 1927
4762	"	Extend Coal Chute 198 ft	"	Nov 1928
4800	"	Construct New 150000 Gal Steel Water Tank	"	Sept 1928
4808	"	Widen 800 ft of present channel of creek North of Round Ho	"	May 1928
4816	"	Construct Spur Track 476 ft long for Mutual Oolitic Co	"	Oct 1928
4817	"	Replace 60 ft Turntable with 100 ft Continuous Deck Table	"	Feb 1929
4824	"	Retire 519 1/2 ft of Coal Track AFE 4273	"	Mar 1928
4896	Bloomington	Purchase Lot 53 in Dodds Addition - Newell Sanders	"	Jan 1928
4916	McDoel	Construct New Track and 135 ft of Track - Johnson Track	"	July 1928
4962	"	Construct New Track 500 ft long in side of Wye	"	Jan 1929
4972	"	Purchase Track "A" 1 & 13 from Ind Limestone Co	"	Dec 1927
5007	Bloomington	Assessment for Improvement of W 2nd St	"	Oct 1928
5076	"	Assessment for Improvement of S Walnut St	"	Nov 1928
5103	"	Install 36'-24" Corr Iron Pipe under Main Track of M.P. 220.1	"	Oct 1928
5279	"	Install 26'-10" Corr Iron Pipe in Adams St	"	Jan 1929
5308	"	Extend Track built under A F E 4816-39 ft Mutual O.S. Co	"	June 1929
5329	McDoel	Construct New Spur 449 ft Johnson Track	"	May 1929
5376	Bloomington	Construct New Track - 580 ft long for Shawnee Stone Co	"	Dec 1929
5444	McDoel	Purchase a 50 ft Strip of Ground from J W Hoadley	"	Feb 1930
5545	Bloomington	Purchase 485 ft of Track built for Shawnee Stone Co	"	Dec 1929
5751	McDoel	Construct Yard Trk & Spur Trk 631 ft long for J M Hoadley	"	July 1930
5973	"	Construct Spur Track 127 1/2 ft long for J M Hoadley Mill	"	Apr 1931
6003		Retire Track 113 From Sta 62+54 to Sta 65+36	"	Mar 1932

End of Sub-Section 2a

Sheet V/12

A.F.E. NOTES

2167	McDoel	Construct Meter Box in Water Line Sta 11686+12.5	Completed	Jan 1920
2114	"	Install Fuel Oil Storage Tank	"	Mch "
2170	"	Connecting Hoadley Siding into Independent lead 28 install Switch etc	"	Apr "
2178	"	Retire X-over 29	"	" "
2459	"	Coach Track Changing 610 ft of 60# Rail, replacing with 75# material	"	Sept "
543	"	Construct Siding for J Hoadley & Sons	"	May 1916
849	"	Extend Siding for J Hoadley & Sons 331 ft	"	Oct "
624	"	Construct Siding for J Hoadley & Sons 450 ft	"	" "
464	"	Install Car 50185 - Coal for Derrick	"	Jan "
1892	Bloomington	Track to National Stone Co 17 Retire 275 ft of Track	"	July 1919
2495	McDoel	Purchase Land - 1313 Ac from Mrs Wylie	"	Nov 1920
1045	"	Install 37 ft 12" Corr Iron Pipe under Side Tracks in Yards	"	Jan 1917
2313	"	Install 2 1/2" Hog Showering Stand Pipe	"	Apr 1921
2691	"	Engine Ho Extend Drain from Turntable = 106 ft 8" Vit Tile	"	Sept "
349	"	Change Light Rail & OTM replacing with 75# material	"	Feb 1916
307	"	Sec 45 Apply 2000 Sellers Tie Plates	"	Apr. "
785	"	Yards Change out Light Rail replacing with 75# material	"	Dec 1917
1811	"	Stone Mill Track 39 Replace 200 ft 60# with 75# Rail	"	Feb 1919
1903	"	Sec 45 - Install 1150 Tie Plates	"	Oct "
2039	"	Indiana Tie & Creosoting Plant - Change out 400 ft of Rail	"	July "
2267	Bloomington	Retire 60 ft 67# and 60 ft 56# Rail in #3 Frt Ho Track & #1 Showers Trk (w/ 75#	"	May 1920
2697	"	Kirkwood Ave Install 2 Conc & Rail X-ings retiring plank + Main Trk & 6 Sec #2971	"	Dec 1921
2786	McDoel	Trk 28 Change out 240 ft 60# Rail replacing with 75# Relay Rail	"	" "
2787	"	Grimes Lane - Raise Grades of 300 ft of Trks 25 26 29 31 33 34 35 & 36 in Const of X ing	"	" "

AFE Notes (For Plat Details See Supplemental Maps)

2302	Bloomington	Track Connection with Bloomington Southern Ry (I.C.R.R.) Length 460 ft	Completed	Aug 1920
725	McDoel	Lengthen Clam Shell Siding 13 63 ft (See Supplemental Map)	"	Apr 1916
1985	"	Conc Platform - 13 x 3 x 74' on Trk 74 with 125 ft 6" Vit Clay Pipe	"	Nov 1919
1117	Bloomington	Lay 3148 ft 6" Vit Sewer Tile in Cuts bet M.P. 118 and M.P. 220 Total Laid on both sides of Trk (Sta 11523+34 to 11612+82) = 4915 feet	"	Oct 1917
726	McDoel	Monroe Oolitic Quarry Co's Siding 125 Lengthen 61 ft (See AFE 724)	"	Apr 1916
2380	Bloomington	Railroad St - Assessment for Sewer	"	July 1920
2625	"	2nd St Install 80-12" Corr I Pipe under So Side Stone Mill Trks at No Gutter Line	"	May 1921
2566	"	Sta 11677+72± Construct SW & Lead 127 1/2 ft for Alex King Stone Co	"	Apr 1921
2586	McDoel	Grimes Lane Assmt for Imprmt also for Retiring 0.05 1/4 Ac land appr for St widening	"	Oct 1921
2618	Bloomington	Trk 33 (Coal No) Move Sw & Lead & Extend Bowman & King St Co's 100 ft also change out 67# Rail in 17 replacing 263 ft with 75# Rail	"	Apr 1921
2666	"	Sta 11645+13 Constr Sw & Lead 130 ft for Curry Coal Co also change out 67# in 9 with 75#	"	June 1921
1749	"	Lay 49 ft 10" Cast Iron Pipe 221 ft So M P 220	"	Oct 1919
394	McDoel	Sta 11724+39 Construct X-over from Main Trk to 86	"	Dec 1915
487	"	Construct Cob House	"	Mch 1916
581	"	Construct Building for Signal Material	"	" "
724	"	(See AFE 726) Lengthen Clinker Pit Trk 74 changing alignment and moving Sw	"	Apr. "
1092	"	Sta 11695+ Construct Coal House	"	Feb 1917
1207	"	Construct 10'x10 Cistern at So End of Engine House	"	May "
1513	"	Construct Conc Box along rear of Engine House	"	" 1919
1588	"	Construct Pipe Line from Tank to Coal Chute	"	Feb "
1981	"	Retire X-over at Transfer Platform	"	Oct "
1630	"	Construct Office & Locker Building	"	July "
1110	"	Construct Siding 637 ft for Coal Trk	"	Nov 1917
1111	"	Construct Siding 874 ft Retire 250 ft & 105 ft	"	" "
1126	"	Construct New Coaling Station	"	Sept "
1475	"	Retire old Sand House	"	Nov "
1611	"	Construct Sand House 10' x 100'	"	" 1918
1751	"	Retire 135 ft of Dead Engine Track 43	"	Sept "
1793	"	Extend Trk leading Turntable 63 ft	"	Oct "
1791	"	Retire Frogs Sw Pts etc in Trk leading to Turntable	"	" "
1620	"	Construct Conc Floor on Turntable	"	Aug 1919
1625	"	Enlarge Building for Mill and Store Room	"	Dec 1918
1166	Bloomington	Install Car 9053 as Transfer Car	"	Apr 1917
1074	"	Install Bump Posts on Gas Co's & Hughes Tracks 13 & 14	"	Feb "
2600	McDoel	Sta 11709+14 Construct Frame Ice Ho & Rearrange Trks etc See Maps 11e, 11e, 11f	"	Apr 1922
2971	Bloomington	Kirkwood Ave Install 3 Conc & Rail X ings retiring plank on Trks 10 11 & 12 See 2697	"	Nov 1922
2977	"	Grimes Lane Improvement Assessment for 150 ft owned by C I & L	"	Aug 1922
2929	McDoel	Shop Grounds - Crushed Stone Surfacing 323 cu yds including screenings	"	Nov 1921
1051	"	Install Tool Car #50192 for Steam Derrick	"	June 1917
1052	"	Install Boarding Car #50257 Converted from Coach #5	"	June 1917
1427	"	Install Fire Hydrant & Hose opposite Wood Mill	"	Feb 1919
1867	"	Install 2 Fire Plugs in Yards	"	Sept 1919
2013	"	Install 2 Bubble Drinking Fountains	"	Sept 1919
870	Bloomington	Repairs & Improvements of Electric Lights in Station	"	Apr 1917
3160	McDoel	Construct Track 120 ft long to Cl Pt (Total length) 605 ft American Ool Stone Co	"	May 1923

NOTE

ICC Track numbers shown thus 86

ICC Track & Contract numbers combined thus 7 AAP

Sheet No of a Series and supplemental Sheets of the Chicago Indianapolis and Louisville Railway Division from Survey Station Station 19 survey

Chief Engineer

RIGHT-OF-WAY AND TRACK MAP V24607

CHICAGO, INDIANAPOLIS & LOUISVILLE RY.

STATION 11561+20 TO STATION 11772+40

SCALE 1IN = 400FT JUNE 30, 1915

Office of Chief Engineer

Chicago, Ill

23.2 x 54.7

V29 11

L.N. 242-A

Revised and Retraced Mar. 17, 1945

JJ M.P. 219 - 223